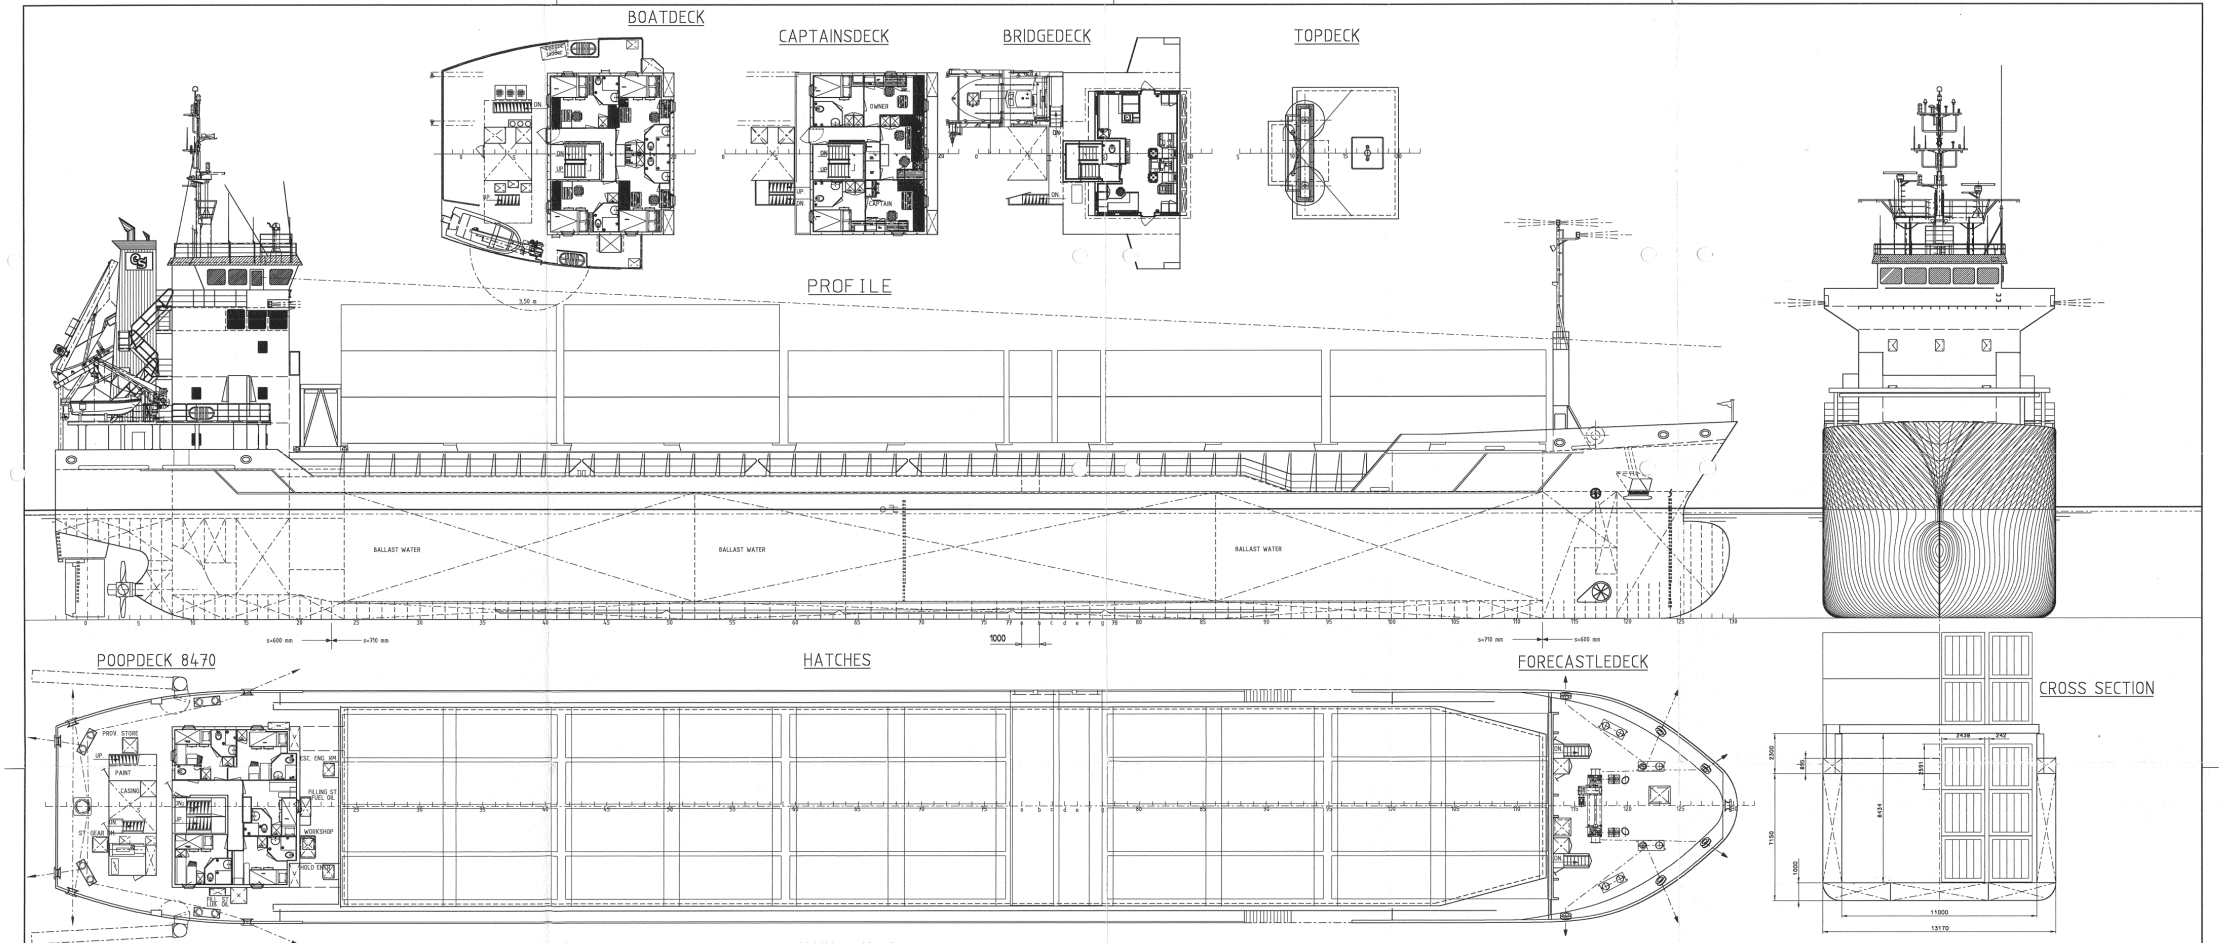

PRINCIPAL PARTICULARS

Length o.a.		95.16 M
Length b.p.p.		90.25 M
Breadth mld.		13.17 M
Depth mld.		7.15 M
Draught mld.		appr. 6.19 M
Deadweight		5049.55 T
Capacities :	Hold	appr. 6196 M3
	Heavy Fuel Oil incl day and sett'l.	appr. 216 M3
	Ballast Water	appr.1727 M3
	Fresh Water	appr. 41 M3
	Gas Oil incl. daytank aux. engines	appr. 44 M3
Containers:	Hold	120 TEU
	on Deck	104 TEU
	Total	224 TEU
Ice class		1C
Speed 90% MCR at 6.19 meter		appr. 12.0 KN
Engine output 100% MCR		2200 kW
Gross tonnage		appr. 2999 GT

DAMEN SHIPYARDS HOOGEZAND

Scheepswerfverweg 13
PO Box 79 9600AB Hoogezand ,HOLLAND
Tel: 0598-380022 Fax: 0598-394863

SCALE	1 : 150	OWNER	CARISBROOKE SHIPPING
DRAWN BY	B. GROOT	DATE	03-06-98
		YARD No.	0731/0742
APPROVED			

TITLE: GENERAL ARRANGEMENT 0731-000-001

ALTERATION	DRAUGHT/DEADW./NUMBER OF CONT.	BY	DATE
J		JH	15-04-99
H	AS BUILT	JB	11-02-99
G	UPDATED	GP	24-11-98
F			
E			

ALTERATION No. A B C D E F G

No. 0731 . CATHARINA C