BOATDECK
CAPTAINSDECK
BRIDGEDECK
TOPDECK
Embarc. ladder
DN.
UP
OWNER
CAPTAIN
3,50 m
PROFILE
BALLAST WATER
BALLAST WATER
BALLAST WATER
s=600 mm
s=710 mm
1000
s=710 mm
s=600 mm
POOPDECK 8470
HATCHES
FORECASTLEDECK
PROV. STORE
PAINT
CASING
ST. GEAR RM.
ESC. ENG. RM.
FILLING ST. FUEL OIL
WORKSHOP
HOLD ENTR.
FILL ST. LUB. OIL
CROSS SECTION
2438
242
2300
895
2591
8434
7150
1000
11000
13170

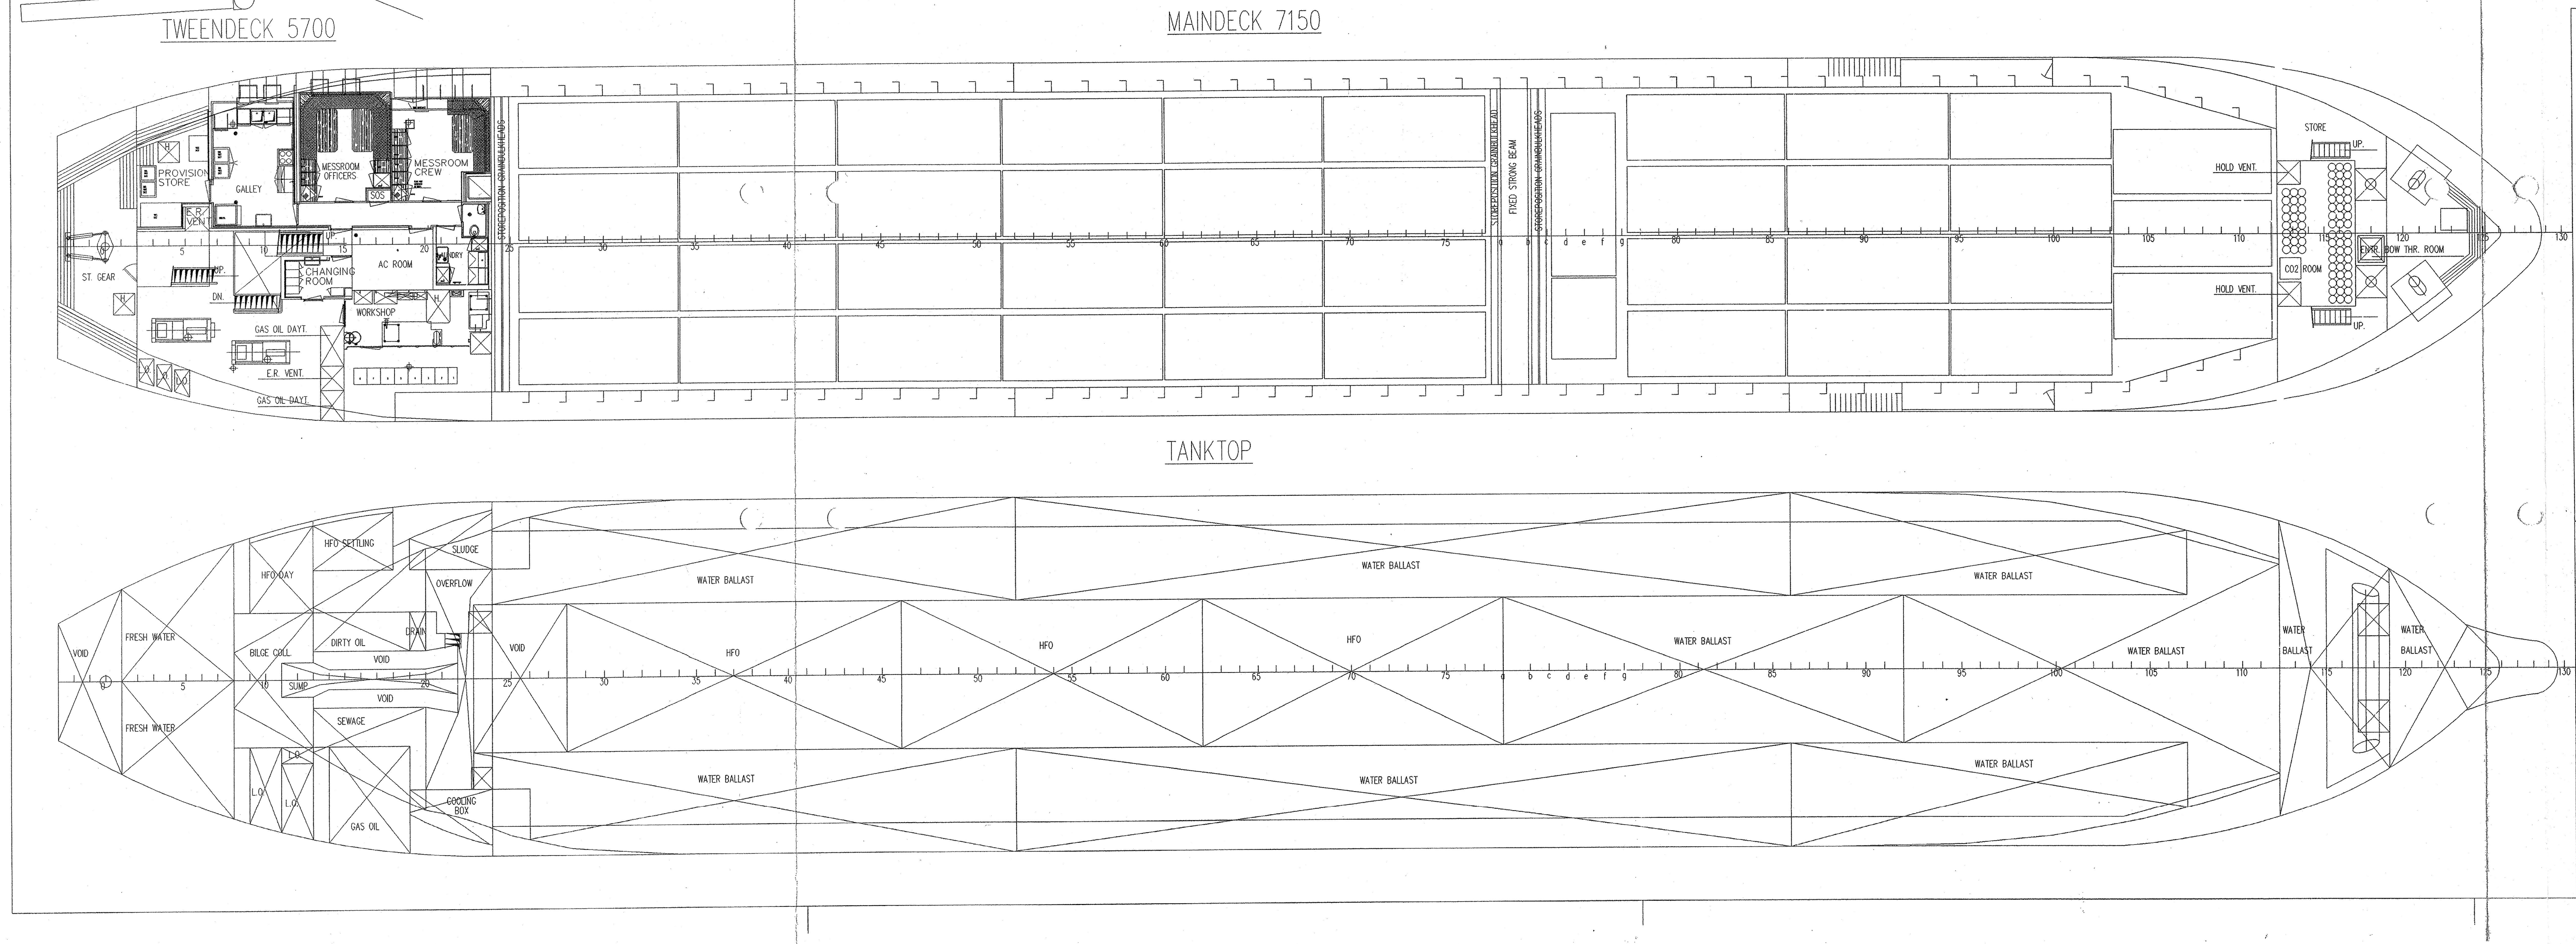
TWEENDECK 5700
MAINDECK 7150
PROVISION STORE
GALLEY
MESSROOM OFFICERS
MESSROOM CREW
SOS
E.R. VENT
ST. GEAR
CHANGING ROOM
AC ROOM
LAUNDRY
WORKSHOP
GAS OIL DAYT.
E.R. VENT.
GAS OIL DAYT.
STOREPOSITION GRAINBULKHEADS
STOREPOSITION GRAINBULKHEAD
FIXED STRONG BEAM
HOLD VENT.
HOLD VENT.
STORE
CO2 ROOM
ENTR.
BOW THR. ROOM
TANKTOP
VOID
FRESH WATER
FRESH WATER
HFO DAY
HFO SETTLING
SLUDGE
OVERFLOW
BILGE COLL.
DIRTY OIL
DRAIN
VOID
SUMP
VOID
SEWAGE
L.O.
L.O.
L.O.
GAS OIL
COOLING BOX
WATER BALLAST
HFO
HFO
HFO
WATER BALLAST
WATER BALLAST
WATER BALLAST
WATER BALLAST
WATER BALLAST
WATER BALLAST
WATER BALLAST
WATER BALLAST

PRINCIPAL PARTICULARS

Length o.a.		95.16 M
Length b.p.p.		90.25 M
Breadth mld.		13.17 M
Depth mld.		7.15 M
Draught mld.		appr. 6.19 M
Deadweight		5049.55 T.
Capacities :	Hold	appr. 6196 M3
	Heavy Fuel Oil incl day and settl.	appr. 216 M3
	Ballast Water	appr.1727 M3
	Fresh Water	appr. 41 M3
	Gas Oil incl. daytank aux. engines	appr. 44 M3
Containers:	Hold	120 TEU
	on Deck	104 TEU
	Total	224 TEU
Ice class		1C
Speed 90% MCR at 6.19 meter		appr. 12.0 KN
Engine output 100% MCR		2200 kW
Gross tonnage		appr. 2999 GT

airdraft foremast 18.9 m in ballastcond

G	AS BUILT	JH	15-04-99
E	UPDATED	JB	11-02-99
E	DRAUGHT/DEADW./NUMBER OF CONT.	GP	24-11-98
No.	ALTERATION	BY	DATE

DAMEN SHIPYARDS HOOGEZAND

Scheepswervenweg 13
PO Box 79 9600AB Hoogezand , HOLLAND
Tel: 0598-380022 Fax: 0598-394863

DATE : - -
READY FOR PRODUCTION
REVISION : --

SCALE	1 : 150	OWNER	CARISBROOKE SHIPPING
DRAWN BY	B. GROOT	DATE	03-06-98
		YARD No.	0731/0742
APPROVED			

TITLE
GENERAL ARRANGEMENT

ALTERATION
A B C D E F G

No. 0731 - 000 - 001